SUBMITTAL COVER SHEET

PROJECT TITLE:	*M/E PROJECT NO.:*
WINN - NYS INSURANCE FUND OFFICES	**240505**

LOG NO.:	*DESCRIPTION:*	*RECEIVED:*
H-4	**FAN COIL UNIT - COILS**	**8/28/25**
	SPEC SECTION NO.: **238216**	

COMMENTS: SUBMITTAL IS MARKED AS INDICATED WITH THE FOLLOWING EXCEPTIONS:	
1.	Final Coil Handedness shall be confirmed with approved sheet metal shop drawings and coordination drawings.
2.	FCU-3-1 supply/return orientation shall be ducted supply and return connections at front and rear. Refer to spec section 23 82 19, Article F, note 8.
3.	Fan coil unit Cabinet color selection by architect.

☐ **NO EXCEPTION TAKEN (NET)**
☐ **REVISE AND RESUBMIT (RR)**
☒ **MAKE CORRECTIONS NOTED (MCN)**
☐ **SUBMIT SPECIFIED ITEM (SSI)**
☐ **REJECTED (REJ)**
☐ _____

Checking is only for general conformance with the design concept of the project and general compliance with the information given in the contract documents. Any action shown is subject to the requirements of the plans and specifications. Contractor is responsible for: dimensions that shall be confirmed and correlated at the job site; fabrication processes and techniques of construction; coordination of its work with that of all other trades; and the satisfactory performance of its work.

M/E ENGINEERING, P.C. ***By:*** *Hunter Stone* ***Date:*** 2025-09-04

Hunter Stone

ELECTRICALLY OPERATED EQUIPMENT: ***Yes*** ☒ ***No*** ☐

IF "YES" – COORDINATION REVIEWED: ***HVAC/Plumbing Designer:*** _____

Electrical Designer: *Jacob C. Leone*

Submittal item detail

#7-0: Coils- Bayshore Mechanical

Status	Created on	Ball in court due date
Open In Review	Aug 28, 2025	Sep 4, 2025

ID	9
Pending action from	**submittal clerk** (M/E Engineering, P.C.)
Ball in court	**submittal clerk** (M/E Engineering, P.C.)
Manager	**SWBR CAClerk** (SWBR)
Responsible contractor	**Stephanie Leary** (Vasile Construction Corp)
Watchers	**Ali Alsaedi** (SWBR)
Spec section	4 Plumbing
Spec sub section	23 82 76.11
Type	Product Data
Description	
Final Response	
Final Response Attachments	
Final Response Comments	
Package	

Ball in court	Sent	Due	Returned	Response/Action	Attachments
Submitted					
Stephanie Leary (Vasile Construction Corp)	-	-	Aug 28, 2025	**Submitted**	Submittal - NYSIF Fan Coil Unit.pdf
Comments	-				
Sent for review					
SWBR CAClerk (SWBR) Sent by SWBR CAClerk	Aug 28, 2025	-	-	**Sent for review**	Submittal - NYSIF Fan Coil Unit.pdf
Comments	-				
Review Step 1					
submittal clerk (M/E Engineering, P.C.)	Aug 28, 2025	Sep 4, 2025	-		
Comments					

BAYSHORE MECHANICAL
1265 Scottsville Rd - Rochester NY 14612
585-435-4011

General Contractor:	Project:
Vasile Construction Corp. 1200 Jefferson Rd., Suite 304 Rochester, NY 14623	Sibley Redevelopement 3rd Floor Job# 2328

TYPE OF SUBMITTAL:

X	PRODUCT DATA	-	TEST REPORT	_	SHOP DRAWING	___	RECORD DOCUMENT
___	SAMPLE	-	CERTIFICATION	_	MFGR COMPLIANCE CERT	___	CLOSEOUT DOCUMENT
___	COLOR SELECTION	-	MFGR DWG	_	SUBSTITUTION	___	OTHER

SUBMITTAL DESCRIPTION: Fan Coil Unit

SUPPLIER/MANUFACTURER: Envirotec

SPECIFICATION SECTION NUMBER & TITLE: 23 82 16.11 Coils

SUB-PARAGRAPH _____ DRAWING NO _____ 1ST TIME SUBMISSION X REVISION # _____

CONTRACTOR'S CERTIFICATION :
I HEREBY CERTIFY THAT I HAVE REVIEWED THIS SUBMITTAL, VERIFIED THE PRODUCTS, VERIFIED FIELD MEASUREMENTS WHERE APPROPRIATE AND HAVE COORDINATED THE INFORMATION WITHIN THIS SUBMITTAL WITH THE REQUIREMENTS OF THE CONTRACT DOCUMENTS. THE SUBMITTED ITEMS COMPLY IN EVERY RESPECT WITH THE REQUIREMENTS OF THE CONTRACT DOCUMENTS AND SPECIFICATIONS.

PRIME CONTRACTOR/CONTRACT/BID
Bayshore Mechanical

SIGNED: Phil Lane

POSITION: **Vice President**

DATE: **8/26/2025**

COMMENTS:

ARCHITECT/ENGINEER REVIEW STAMP:

CONSTRUCTION MANAGER USE: SUBMITTED AND REVIEWED BY LECHASE CONSTRUCTION SERVICES, LLC AS COMPLYING WITH PROJECT SPECIFICATIONS AND DRAWINGS

Approved By:	**REVISION NO.**
	DATE:

MODULAR COMFORT SYSTEMS

a member of DAIKIN group

SUBMITTAL DATA

PROJECT:

Sibley Building 3rd Floor Renovations

FW-25-08-032

CUSTOMER:

Bayshore Mechanical
1265 Scottsville Rd
Rochester, NY 14624

Attn: Phil Lane

SUBMITTED BY:

Modular Comfort Systems, Inc.
660 W Metro Park
Rochester, NY 14623

CONTACT: Kyle Ashe
(585) 398-8018

Equipment:	Qty (1) ETI Fan Coil Unit	(Spec 238219)
Job Notes:	Please see included information.	
Date:	8/26/25	

Sibley Building 3rd Floor Alterations:

Energy Recovery Ventilators Submittal Notes Page:

1. Envirotec Fan Coil Unit

Tag	Qty	Model	Return/Supply Orientation
FCU-3-1	1	HLE-D08	Bottom Return Grill/End Supply Grill (Please Confirm)

Equipment Summary

- Left Hand CW Connection
- Disconnect Switch
- 3-Speed Unit Mounted Fan Speed Switch
- Chilled Water Coil
- ECM Motor
- MERV-8 Filter
- S.S. Drain Pan
- Condensate Float Switch
- Color Selection by Architect
- Please Note: Contractor to confirm handing prior to release.
- **EXCLUDES: Hose Kit, Control Valves, Thermostats, Control or Power Wiring, Installation,**

CATALOG

HL Fan Coil Units Low-Profile, Horizontal Series D



ENVIRO-TEC

FEATURES AND BENEFITS

HIGH PERFORMANCE

ENVIRO-TEC® HL Series horizontal low profile fan coil units are designed to maximize flexibility of selection and installation.

The units are also designed to exceed the stringent quality standards of the institutional market, while remaining cost competitive in the light commercial segment of the market.

ENVIRO-TEC® horizontal fan coil units set the standards for quality, flexibility, and competitive pricing.

DESIGN FLEXIBILITY

The extensive variety of standard options available on the HL Series units are where you find the versatility to fit any HVAC system designer's needs.

Options include: rear or bottom return, rear ducted return, solid or telescoping bottom panels for unit recessing, single wall stainless steel drain pans, electric heat and condensate pumps with single point power connection. All electric heat units are listed with cETLus as an assembly and carry the cETLus label.

Units comply with the latest edition of AHRI Standard 440 for testing and rating fan coil units, are certified, and display the AHRI symbol.

High Efficiency motors, fan relays, disconnects and fusing mean easier coordination between mechanical and electrical trades.

Coil options allow for 2 through 6 row chilled water coils. One or two row hot water or standard steam coils may be placed in the preheat or reheat position.

Silent solid state relays are available for electric heat control in sound sensitive environments.

CONVENIENT INSTALLATION

HL Series fan coil units are shipped completely assembled, reducing field installation time and labor. All units are thoroughly inspected and tested prior to shipment, reducing potential problems at startup. Motor wiring is brought to a junction box on the outside of the unit casing, reducing electrical hook-up time.

HL Series fan coil units have an electrical enclosure on the side of the unit. The expansive compartment allows for easy access to electrical components, terminal blocks and wiring.

Factory furnished valve packages assure proper fit, operation and performance.

QUALITY PRODUCT

Concealed Model HL Series fan coil units are built from galvanized steel. Exposed Model HLE cabinetry is powder coated galvannealed steel.

Standard insulation is 3/8" elastomeric closed cell foam, complying with UL 181 and NFPA 90A.


Units, with or without electric heat, are cETLus listed and labeled. All wiring is in compliance with NEC.

HL Series fan coil units have a removable fan assembly. The entire fan assembly can be removed from the unit and serviced easily on a workbench.

CONSTRUCTION FEATURES

MODEL HLP

HL Series fan coils have many standard and optional features which are unique to the industry (see page 6 for a complete listing).

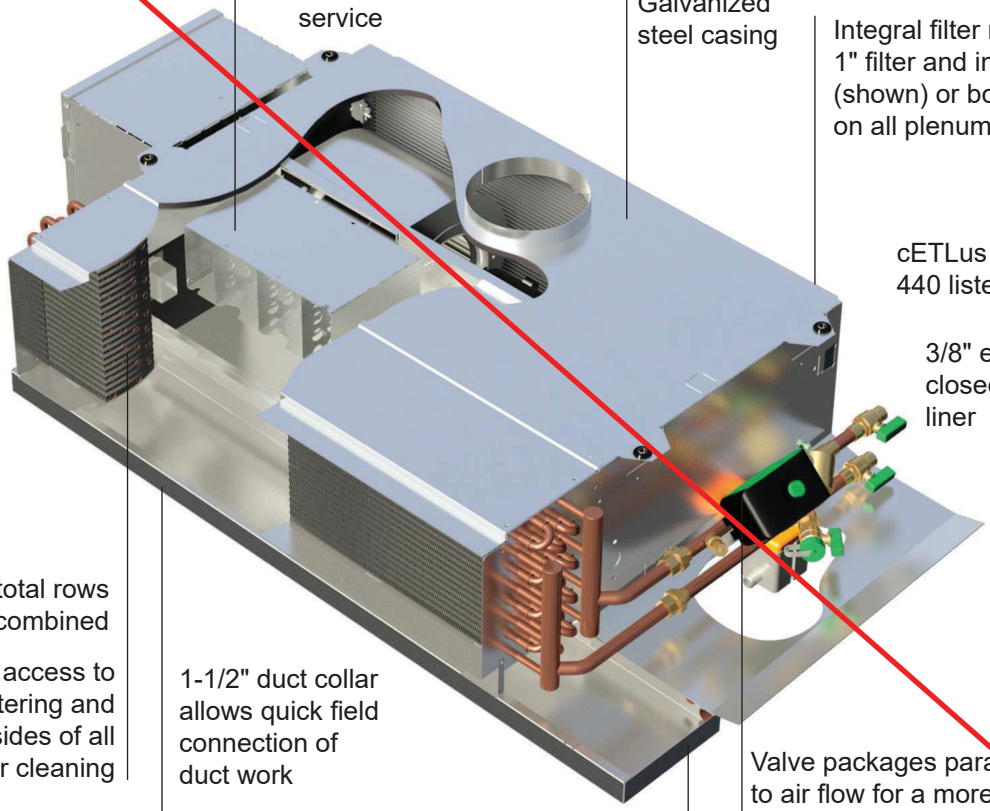

Single point power connection on all units including electric heat

Removable fan board for ease of access and service

Galvanized steel casing

Integral filter rack with 1" filter and integral rear (shown) or bottom return on all plenum units

Permanently lubricated, three tap, PSC fan motors designed for quiet and efficient operation. Optional ECM with standard and high static options

cETLus and AHRI 440 listed and labeled

3/8" elastomeric closed cell foam liner

Maximum 6 total rows of coil combined

Bottom access to both entering and leaving sides of all coils for cleaning

1-1/2" duct collar allows quick field connection of duct work

Valve packages parallel to air flow for a more compact unit

Drain pans can be easily removed for cleaning without the use of tools

Single wall galvanized or optional stainless steel drain pans are double sloped to drain connections


Optional secondary drain connection for added security (not shown)

Optional factory mounted valve packages

Optional factory mounted condensate pumps with single point power


MODEL HLE

Horizontal Exposed Cabinet

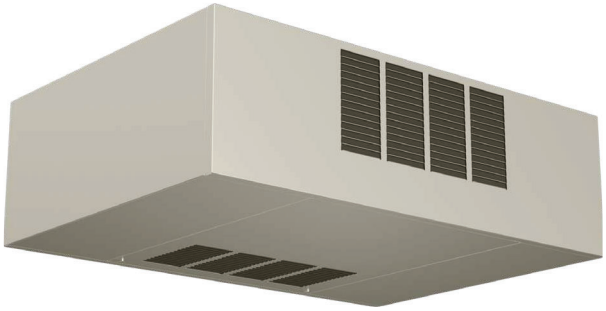


MODEL HLF

Horizontal Free Return

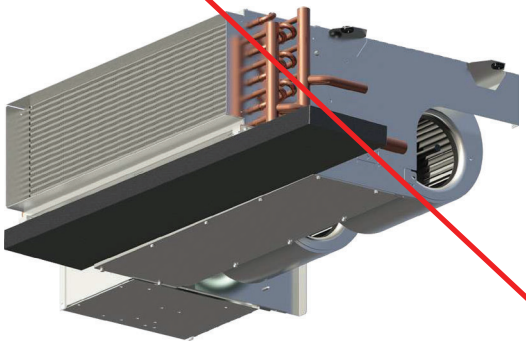


CONSTRUCTION FEATURES

MODELS HLF/HLP/HLE

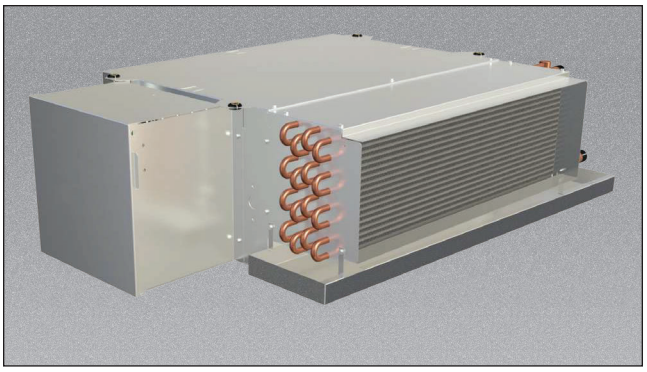

ELECTRICAL ENCLOSURE

The bottom access electrical enclosure with additional side access provides access to a spacious electrical compartment. This compartment houses electric heat and control components. Terminal strips are furnished for simple power and control wiring connections. Multiple knockouts allow wiring entries from either side of the compartment.

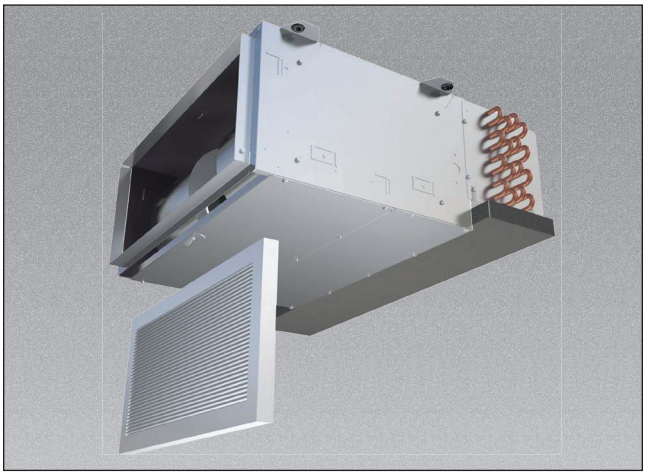


FILTERS

One inch throwaway filters are tight fitting to prevent air bypass. Filters are easily removable from the bottom of the unit.


COILS

All fan coils are available in 2 or 4 pipe configurations. The heating coil may be placed in the reheat or preheat position. Heating and cooling coils are available with right, left or opposite side connections.

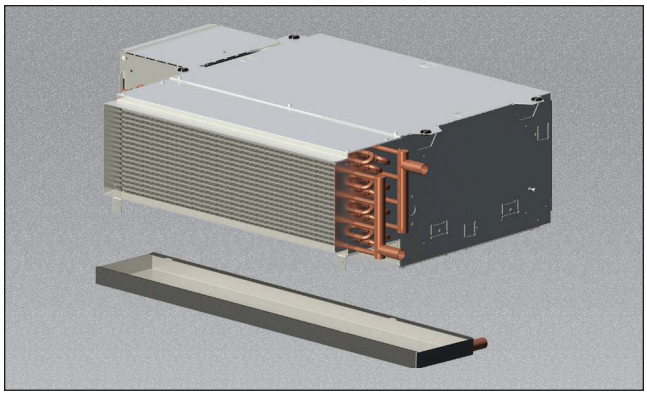


DRAIN PAN

The HL Series drain pan is easily removable for cleaning, utlitizing a patent-pending tool-free design. Standard drain pans are single wall galvanized steel with an option for stainless steel. Drain pans are available with secondary drain connection. All drain pans are externally insulated with closed cell foam.

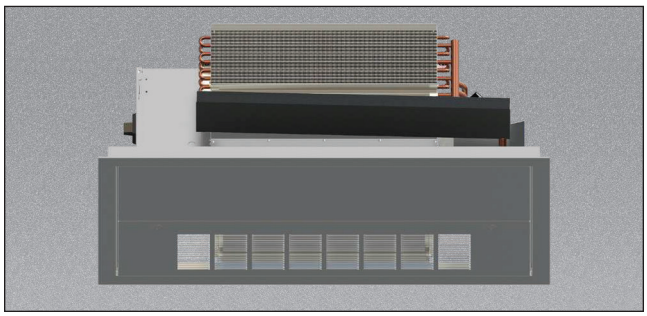

TELESCOPING BOTTOM PANEL

The telescoping bottom panel allows for fully recessing the unit while permitting service access into the ceiling plenum. The architectural ceiling panel is finished with a durable powder coat paint.

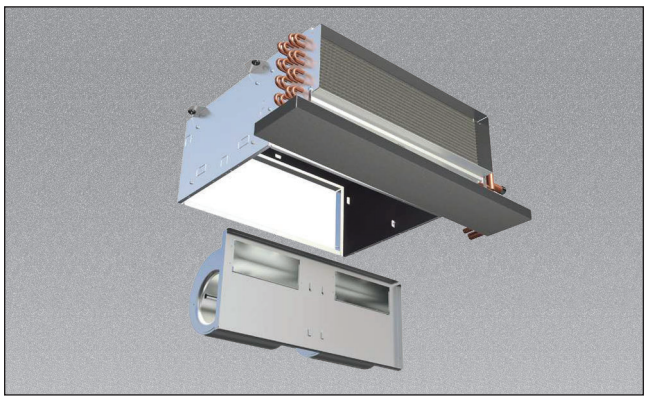

FAN DECK

The fan assembly is easily removed without disconnecting the ductwork for service access to motors and blowers at, or away from the unit.

STANDARD AND OPTIONAL FEATURES

STANDARD FEATURES

Construction

All Units

- AHRI 440 certified and labeled
- 3/8" elastomeric closed cell foam insulation
- Galvanized steel construction
- 1 1/2" duct discharge collar
- Four point hanger mounting brackets

Plenum units

- Integral filter rack with 1" throwaway filter
- Integral rear return

Exposed units

- Stamped louver supply and return air grilles
- Durable powder coat paint
- 18 gauge bottom panel construction

Coils

- Cooling - 2 to 6 row chilled water
- Heating - 1 or 2 row hot water or steam – reheat or preheat position
- 6 total rows of cooling and heating coils maximum
- 3/8" coil tube diameter
- 10, 12 or 14 fins per inch
- High efficiency aluminum fin surface for optimizing heat transfer and air pressure drop
- Left or right hand, same or opposite side connections on four pipe systems
- Access to entering and leaving air sides for cleaning
- Removable for service
- Manual air vents

Drain Pans

- Single wall, galvanized steel, externally insulated – fire retardant and antimicrobial
- Double sloped to drain connection
- Tool-free removal
- 7/8" primary drain connection

Fan Assemblies

- Forwardly curved, DWDI centrifugal type
- 115 volt, single phase, three speed PSC motors
- Quick disconnect motor connections
- Removable fan/motor deck for service

Electrical

- cETLus listed for safety compliance
- Electrical junction box for field wiring terminations

Electric Heat

- cETLus listed as an assembly for safety compliance
- Integral electric heat assembly with removable elements for easy service
- Automatic reset primary and back-up secondary thermal limits
- Single point power connection

OPTIONAL FEATURES

Construction

All units

- Rubber isolated hanger brackets

Plenum units

- Bottom return
- Rear ducted return
- 1" pleated filters (MERV 8 & 13)
- Spare 1" throwaway filters
- Telescoping bottom access panels

Exposed units

- 1" pleated filters (MERV 8 & 13)
- Double deflection discharge grille
- Ducted supply and/or return

Coils

- 1/2" coil tube diameter
- Automatic air vents
- Stainless steel coil casings

Drain Pans

- Stainless steel construction with external insulation
- 5/8" secondary drain connection
- Auxiliary drip pans, galvanized or stainless steel

Condensate Pump

- Single point power
- Plenum rated
- Maintenance free
- Quiet operation

Piping Packages

- Factory assembled – shipped loose for field installation
- Unit mounted - shipped from factory with structural supports
- 1/2" and 3/4", 2 way and 3 way normally closed, two position electric motorized valves
- Floating point modulating control valves
- 0-10V proportional control valves
- High pressure close-off actuators (125 PSIG)
- Isolation ball valves with memory stop
- Fixed flow control devices
- Unions and P/T ports
- Y strainer with blowdown

Thermostats

- Remote mounted analog, digital display or programmable
- 2 and 4 pipe control sequences
- Automatic and manual changeover
- Integral three speed fan switches
- 24V floating point control
- 0-10V proportional control

Fan Assemblies

- 277 volt, single phase, three speed PSC motors
- 115, 208-230 & 277V, single phase, three speed EC motors
- 115, 208-230 & 277V, single phase, high static three speed EC motors
- 115, 208-230 & 277V, single phase, variable speed EC motors

Electrical

- SCR fan speed controller (high speed only)
- Integrated circuit board with fan relays and on board transformer
- Toggle disconnect switch
- Condensate overflow switch (drain pan)
- Main fusing
- Unit and remote mounted 3-speed fan switches
- Freezestat
- Dirty filter switch
- Discharge air temperature sensor

Electric Heat

- Door interlocking disconnect switch
- Main fusing
- Silent relay/contactors

ENVIRO-TEC

Performance Data Sheet

Project Name:	Sibley Building 3rd Floor Renovations	ETI Contract No:	Contract #
Location:		Coil Version:	7.05b
Consultant/Engineer:		Printed Date:	8/26/2025 3:20:18 PM
Contractor:		Selection Date:	7/11/2025 11:15:23 AM
Sold To:		Last Revision Date:	8/26/2025 3:19:58 PM
P.O. No:	PO		

Unit Tag	Qty	Model	Air Flow	Total Duty	Sensible Duty
FCU-3-1	1	HLE-D08	500 CFM	12,994 Btuh	10,814 Btuh

Unit Data

Model Size	: 08	(Fans) Speed	: (2) Medium	Filter	: 1" Pleated (MERV 8)	Coil Tube Dia.	[in.] 3/8
Type	: Horizontal Low Profile - Series D	(Motors) HP	: (1) 1/4	Filter (Qty) Size	: (2) 19 x 9.25 x 1	Coil Face Area	[ft²] 2.11
		Motor FLA	: 2.9	Filter Face Area	[ft²] 2.44	Weight*	[lb] 134
		Motor Type	: ECM 3 SPD				
		Capacity	: High Capacity				

Output Data

Altitude	[Ft.]	0
Air Flow Rate	[CFM]	500
ESP	[in.wg]	0.08
Chilled Water Coil Data		
EAT DB/WB	[°F]	75.0/ 63.0
LAT DB/WB	[°F]	55.2/ 54.0
Total Capacity	[Btuh]	12,994
Sensible Capacity	[Btuh]	10,814
EWT/LWT	[°F]	44.0/ 58.1
Fluid Flow	[gpm]	1.90
Fluid P.D	[ft.wg]	2.78
Fluid Velocity	[fps]	1.90
Rows / FPI / Circuits	:	4 Row / 10 FPI / 3 Ckt
Coil Connection Size:	[in.]	0.875
Heating Data		
EAT DB	[°F]	-
LAT DB	[°F]	-
Sensible Capacity	[Btuh]	-
Rows / FPI / Circuits	:	- / - / -

Options

1" Pleated Spare Filter (MERV 8) (1)
Access Latches- Standard
BC02 24V, Unit S/S Relay / Fan Op. Relay & Transformer
Elastomeric Closed Cell Foam Insulation
Enclosure Mount- Unit Mounted
Motor Control- 3 Speed Fixed
OC011 Drain Pan Float Switch
OC012 Toggle Disconnect Switch - 15 amps
OC019 Unit Mounted 3 Speed Switch with Off Position
Paint Options- Pearl White Satin
Return Air Options- Return: Bottom Stamped Louver Grille
Stainless Steel Unit Drain Pan
Supply Air Options- Supply: Stamped Louver Grille
Thermostat Location- No Thermostat
Thermostat- No Thermostat
Chilled Water Coil: Field Provided Piping Package Size - 1/2"
Chilled Water Coil:Galvanized Casing
Chilled Water Coil:Left Hand Connection
Chilled Water Coil:Manual Air Vent
Chilled Water Coil:Package Code- Field Provided by Others 1/2" Valve Package

Special Quote (SQ)#	Special Quote (SQ)#	Special Quote (SQ)#	Special Quote (SQ)#


Electrical Data


Motor Voltage	**[V/P/HZ]**	**115/1/60 ECM 3 SPD**
Total Full Load Amps	**:**	**2.90**
MCA / MSCP	**:**	**3.63 / 15.00**
Fan Power Input	**[Watts@CFM]**	**60.00**

Sound Data at Medium Fan Speed							
	125Hz	250Hz	500Hz	1kHz	2kHz	4kHz	8kHz
Total	58	61	58	56	50	44	35


- *** Unit weight includes unit with wet coil(s) as selected.**
  - **Does not include accessories**
- **Unit pressure drop and air flow based upon dry coil as required by AHRI-440.**
- **Sound data tested in accordance with AHRI-350-2015**
- **Total sound power level data based on Horizontal Ceiling Exposed Cabinet FCU Model with fan air flow at corresponding motor tap with 115/1/60 volt ECM 3 SPD motor, 4 row coil, 1" throwaway filter, unit standard insulation, 0.00 in.wg external static pressure and standard rated internal pressure losses.**
- **Scheduled motor information is for Fan Input Power at High Speed.**
- **For 0' altitude the coil selection has been made at Standard Conditions.**



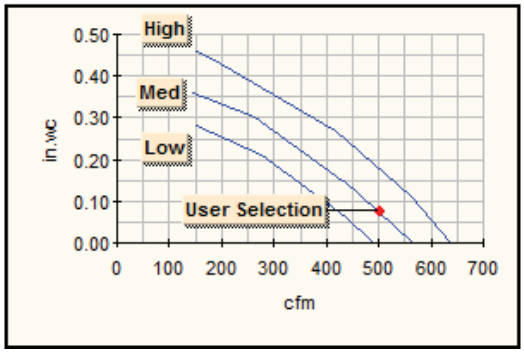


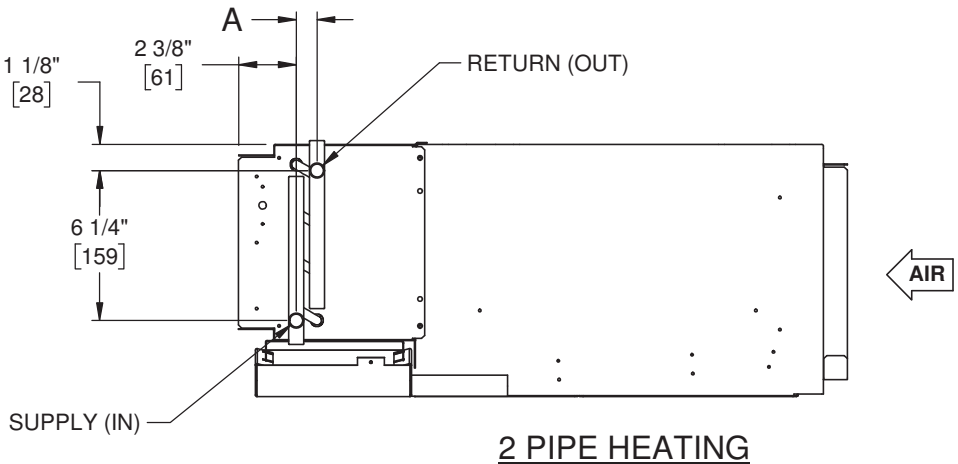

2 PIPE HEATING
LEFT HAND

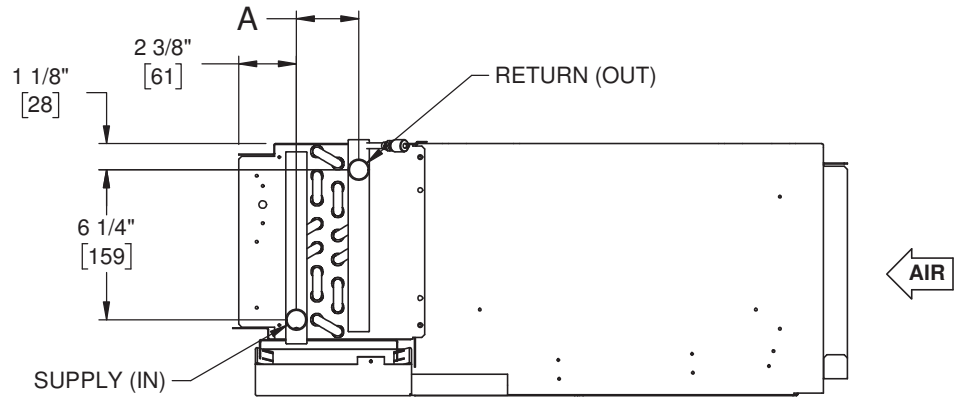

2 PIPE COOLING
LEFT HAND

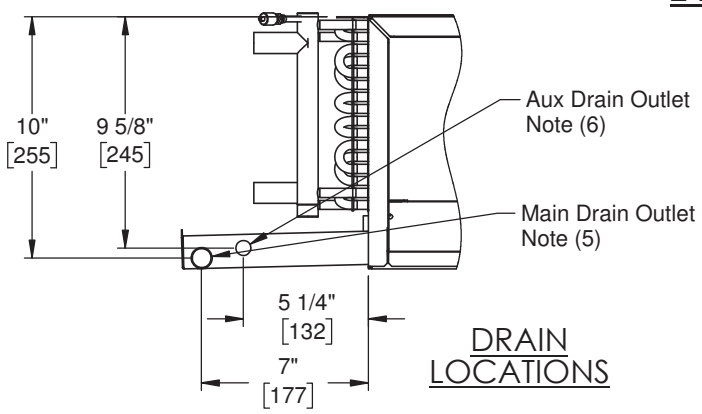

DRAIN LOCATIONS

Unit Type	Coil Rows	A
2 Pipe Heating	1	1" [25]
	2	7/8" [22]
2 Pipe Cooling	2	1 1/8" [29]
	3	1 3/4" [44]
	4	2 5/8" [67]
	5	3 1/2" [89]
	6	4 3/8" [111]

NOTES:
1. All dimensions are inches [millimeters]
   All dimensions ±1/2 [13mm].
   Mectric values are soft conversion.
2. All drawings subject to change without notice.
3. Model "HLP" unit shown, typical for model "HLF" units. Connections shown are internal on "HLE" units.
4. Connection Size:
   Chilled Water: 7/8 ODM (3/4" NOM.)
   Hot Water: 5/8 ODM (1/2" NOM.)
5. Standard externally foam coated galvanize steel drain pan has 7/8" ODM copper outlet. Stainless steel drain pan has 3/4" MPT galvanize steel outlet.
6. Aux. drain outlet is 5/8" ODM copper or 3/8" MPT galvanized steel respectively. Aux. drain outlet is always on viewer's left when facing outlet end of drain pan, regardless of unit hand.

ENVIRO-TEC®

THIS DRAWING CONTAINS PROPRIETARY DATA. UNAUTHORIZED DISCLOSURE, REPRODUCTION, OR USE IS STRICTLY PROHIBITED WITHOUT WRITTEN PERMISSION.


SUBMITTAL DRAWING
ALL DRAWINGS ARE SUBJECT TO CHANGE WITHOUT PRIOR NOTICE

DO NOT SCALE DRAWING
DIMENSIONS ARE IN INCH [MM] FORMAT
+/- 1/8 [3] UNLESS OTHERWISE NOTED


TITLE: **MODEL HLP/F FAN COIL UNIT SERIES D WATER COIL CONNECTION LOCATIONS**


DATE	SHEET	DRAWING NO	REV
01/12/18	PAGE 1 OF 3	47-80115	01

UNCONTROLLED WHEN PRINTED

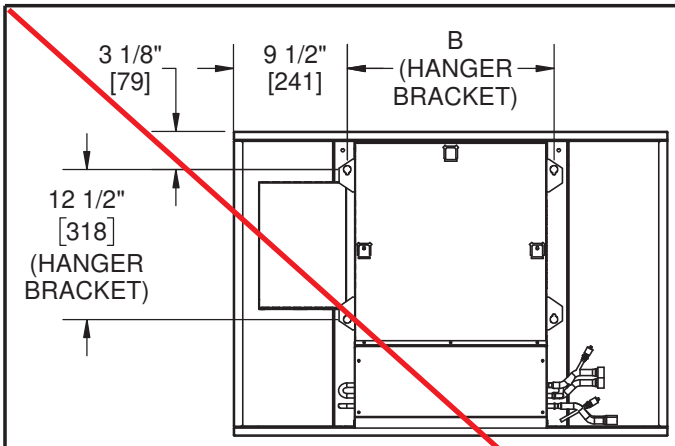


TOP VIEW

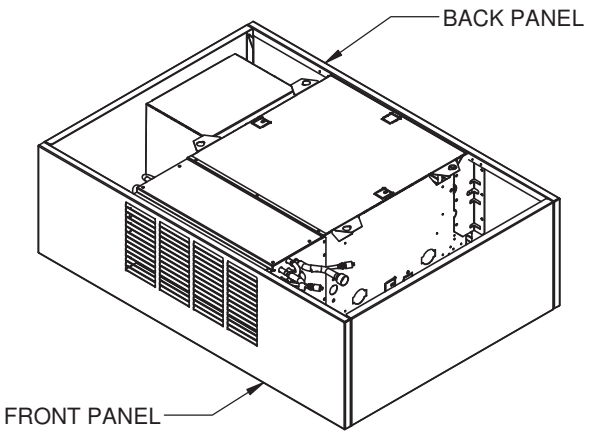


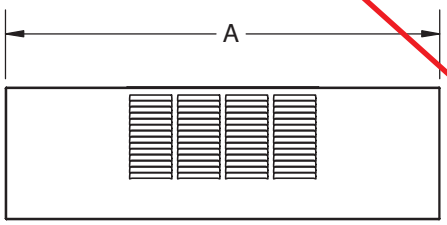

FRONT VIEW

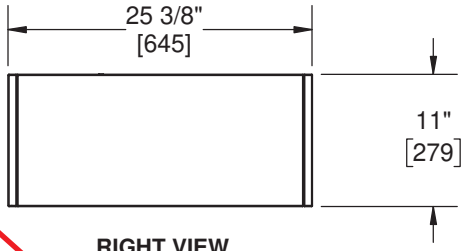

RIGHT VIEW

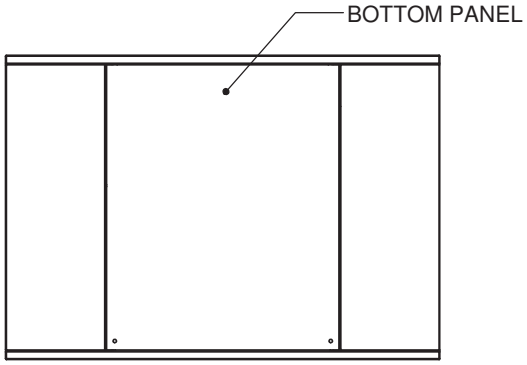

BOTTOM VIEW

DIMENSIONS		
UNIT SIZE	A	B
02	36 1/4" [921]	17 1/4" [438]
03	39 1/2" [1003]	20 1/2" [521]
04	44 1/2" [1130]	25 1/2" [648]
06	51 1/4" [1302]	32 1/4" [819]
08	58 1/4" [1480]	39 1/4" [997]
09	62 1/2" [1588]	43 1/2" [1105]
10	72 1/4" [1835]	53 1/4" [1353]
12	80 1/4" [2038]	61 1/4" [1556]

NOTES:

1. All dimensions are inches [millimeters]. All dimensions ±1/4"[6mm]. Metric values are soft conversions.
2. Left hand unit shown, right hand unit opposite.
3. Provide sufficient clearance to access electrical controls and comply with applicable codes and ordinances.
4. Drain piping should be routed through casing opening indicated to provide proper slope.
5. Bottom panel removable for access to filter and fan assembly.
6. Corner panels are removable to access electrical enclosure, coil and valve pack.
7. Internal insulation of field piping may be required.
8. Field piping casing penetrations must be cut in the field to match individual job requirements.
9. All dimensions also apply to units with Electric Heat Only.

UNCONTROLLED WHEN PRINTED

ENVIRO-TEC®


THIS DRAWING CONTAINS PROPRIETARY DATA. UNAUTHORIZED DISCLOSURE, REPRODUCTION, OR USE IS STRICTLY PROHIBITED WITHOUT WRITTEN PERMISSION.

SUBMITTAL DRAWING
ALL DRAWINGS ARE SUBJECT TO CHANGE WITHOUT PRIOR NOTICE


DO NOT SCALE DRAWING
DIMENSIONS ARE IN INCH [MM] FORMAT
+/- 1/8 [3] UNLESS OTHERWISE NOTED


TITLE: **MODEL HLE EXPOSED FAN COIL UNIT SERIES D REAR RETURN**

DATE	SHEET	DRAWING NO	REV
10/4/19	PAGE 1 OF 2	47-80116	A

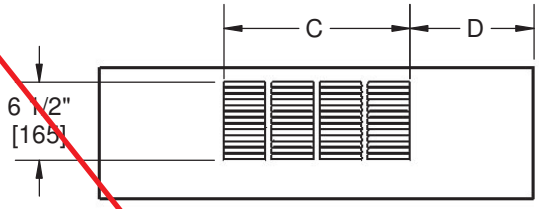


FRONT PANEL
LOUVERED SUPPLY

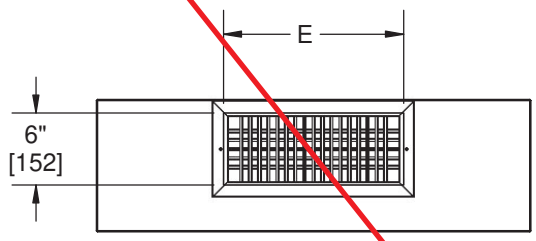


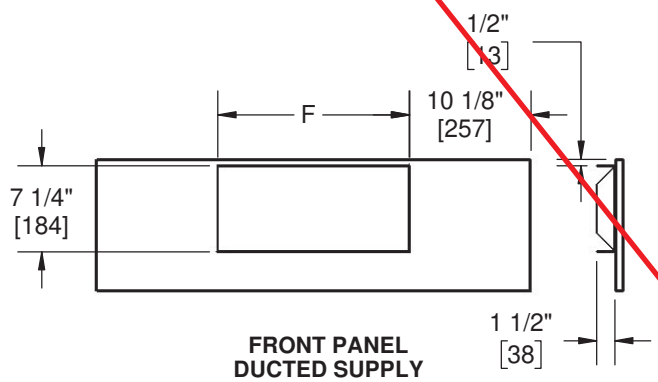


FRONT PANEL
DUCTED SUPPLY

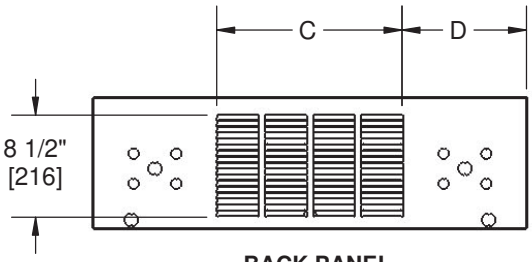

BACK PANEL
LOUVERED RETURN

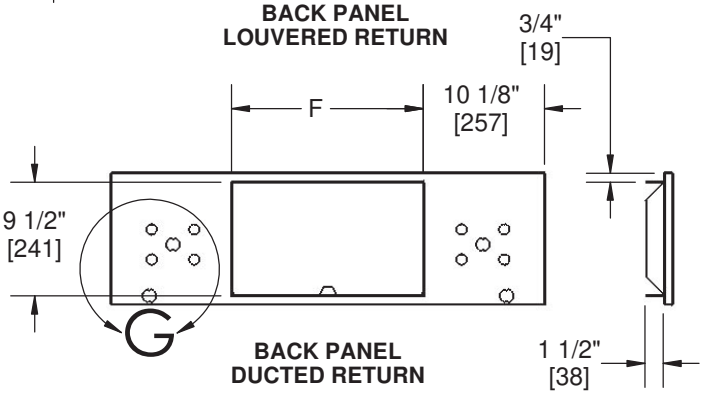

BACK PANEL
DUCTED RETURN

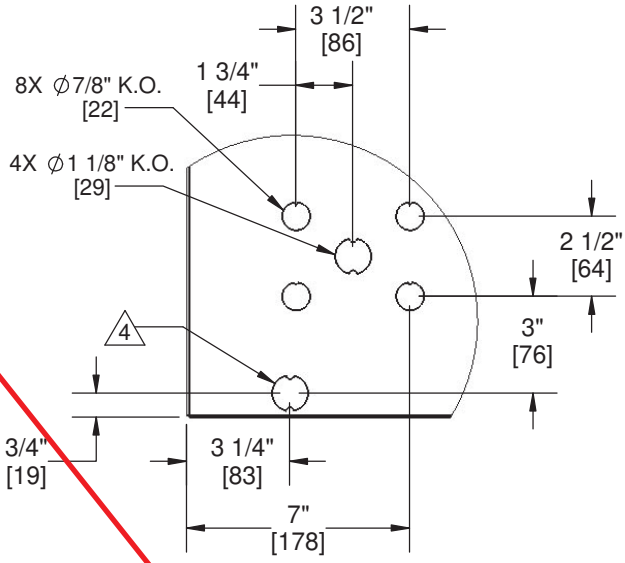

DETAIL G

NOTES:

1. All dimensions are inches [millimeters]. All dimensions ±1/4"[6mm]. Metric values are soft conversions.
2. Left hand unit shown, right hand unit opposite.
3. Provide sufficient clearance to access electrical controls and comply with applicable codes and ordinances.
4. Drain piping should be routed through casing opening indicated to provide proper slope.
5. Bottom panel removable for access to filter and fan assembly.
6. Corner panels are removable to access electrical enclosure, coil and valve pack.
7. Internal insulation of field piping may be required.
8. Field piping casing penetrations must be cut in the field to match individual job requirements.
9. All dimensions also apply to units with Electric Heat Only.

DIMENSIONS

UNIT SIZE	C	D	E	F
02	15 1/2" [394]	10 3/8" [264]	15" [381]	16" [406]
03	15 1/2" [394]	12" [305]	18" [457]	19 1/4" [489]
04	23 1/2" [597]	10 1/2" [267]	23" [584]	24 1/4" [616]
06	27 1/2" [699]	11 7/8" [302]	30" [762]	31" [787]
08	35 1/2" [902]	11 3/8" [289]	37" [940]	38" [965]
09	39 1/2" [1003]	11 1/2" [292]	41" [1041]	42 1/4" [1073]
10	51 1/2" [1308]	10 3/8" [264]	23" [584]	52" [1321]
12	59 1/2" [1511]	10 3/8" [264]	27" [686]	60" [1524]

UNCONTROLLED WHEN PRINTED

ENVIRO-TEC®


THIS DRAWING CONTAINS PROPRIETARY DATA. UNAUTHORIZED DISCLOSURE, REPRODUCTION, OR USE IS STRICTLY PROHIBITED WITHOUT WRITTEN PERMISSION.

SUBMITTAL DRAWING
ALL DRAWINGS ARE SUBJECT TO CHANGE WITHOUT PRIOR NOTICE


DO NOT SCALE DRAWING
DIMENSIONS ARE IN INCH [MM] FORMAT
+/- 1/8 [3] UNLESS OTHERWISE NOTED


TITLE: **MODEL HLE EXPOSED FAN COIL UNIT SERIES D REAR RETURN**

DATE	SHEET	DRAWING NO	REV
10/4/19	PAGE 2 OF 2	47-80116	A

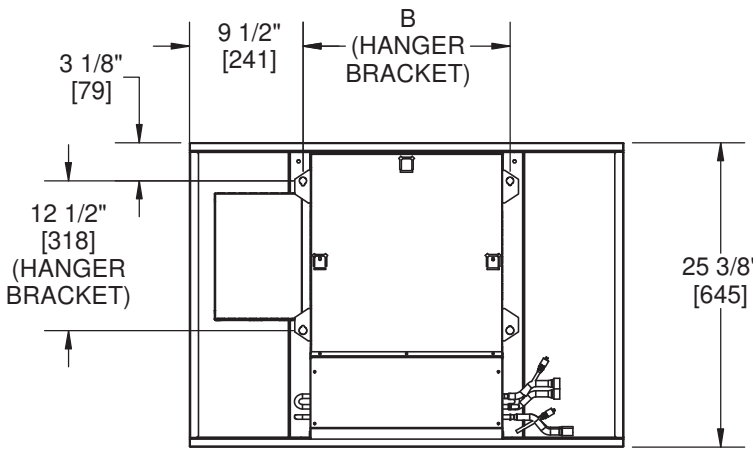

TOP VIEW

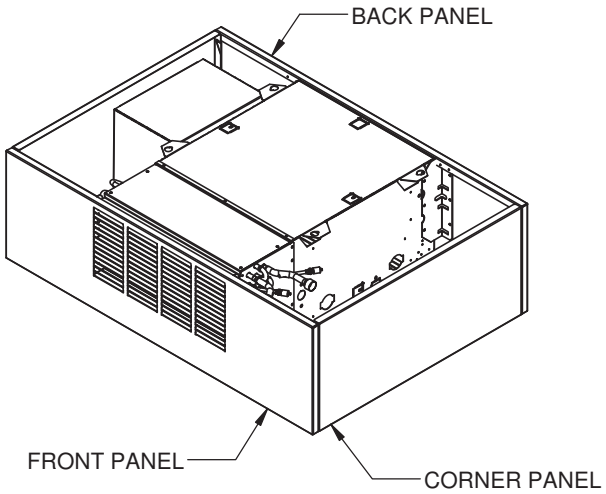


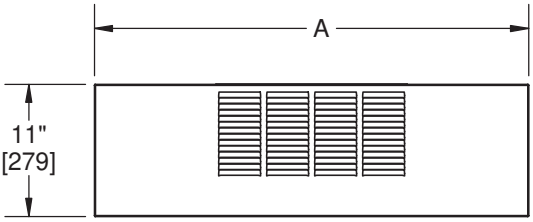

FRONT VIEW



RIGHT VIEW

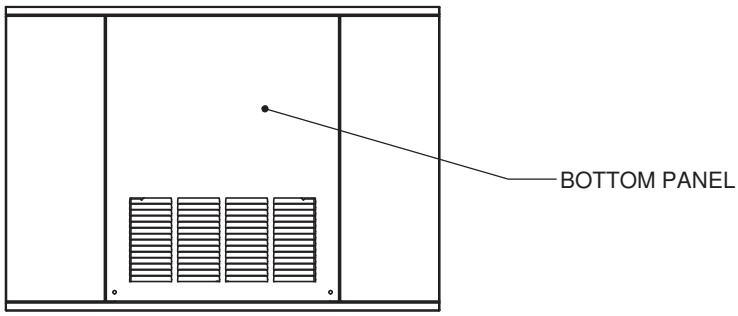

BOTTOM VIEW

DIMENSIONS		
UNIT SIZE	A	B
02	36 1/4" [921]	17 1/4" [438]
03	39 1/2" [1003]	20 1/2" [521]
04	44 1/2" [1130]	25 1/2" [648]
06	51 1/4" [1302]	32 1/4" [819]
08	58 1/4" [1480]	39 1/4" [997]
09	62 1/2" [1588]	43 1/2" [1105]
10	72 1/4" [1835]	53 1/4" [1353]
12	80 1/4" [2038]	61 1/4" [1556]

NOTES:

1. All dimensions are inches [millimeters]. All dimensions ±1/4"[6mm]. Metric values are soft conversions.
2. Left hand unit shown, right hand unit opposite.
3. Provide sufficient clearance to access electrical controls and comply with applicable codes and ordinances.
4. Drain piping should be routed through casing opening indicated to provide proper slope.
5. Bottom panel removable for access to filter and fan assembly.
6. Corner panels are removable to access electrical enclosure, coil and valve pack.
7. Internal insulation of field piping may be required.
8. Field piping casing penetrations must be cut in the field to match individual job requirements.
9. All dimensions also apply to units with Electric Heat Only.

UNCONTROLLED WHEN PRINTED

ENVIRO-TEC®


THIS DRAWING CONTAINS PROPRIETARY DATA. UNAUTHORIZED DISCLOSURE, REPRODUCTION, OR USE IS STRICTLY PROHIBITED WITHOUT WRITTEN PERMISSION.

SUBMITTAL DRAWING
ALL DRAWINGS ARE SUBJECT TO CHANGE WITHOUT PRIOR NOTICE


DO NOT SCALE DRAWING
DIMENSIONS ARE IN INCH [MM] FORMAT
+/- 1/8 [3] UNLESS OTHERWISE NOTED


TITLE: **MODEL HLE EXPOSED FAN COIL UNIT SERIES D BOTTOM RETURN**

DATE	SHEET	DRAWING NO	REV
10/4/19	PAGE 1 OF 3	47-80117	B

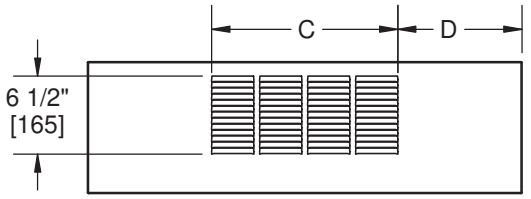


FRONT PANEL
LOUVERED SUPPLY

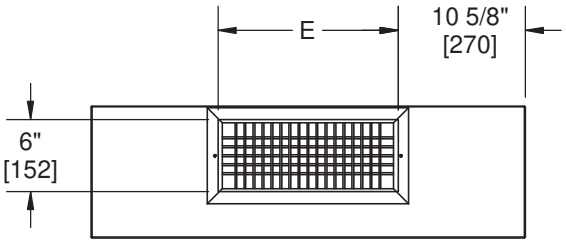


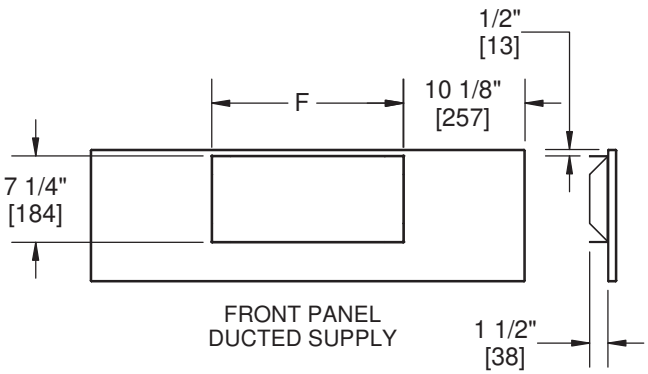


FRONT PANEL
DUCTED SUPPLY

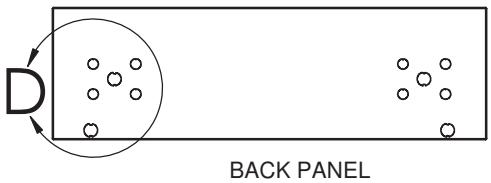

BACK PANEL
BOTTOM RETURN

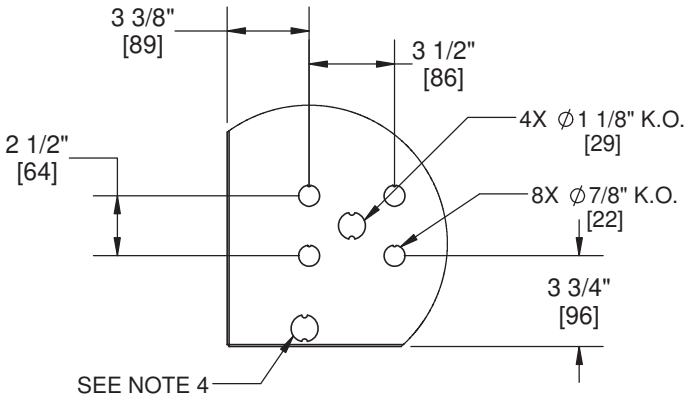

DETAIL D

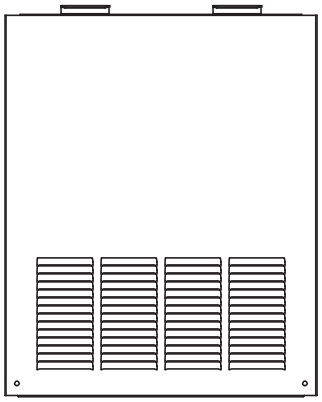

BOTTOM PANEL
BOTTOM RETURN

DIMENSIONS

UNIT SIZE	C	D	E	F
02	15 1/2" [394]	10 3/8" [264]	15" [381]	16" [406]
03	15 1/2" [394]	12" [305]	18" [457]	19 1/4" [489]
04	23 1/2" [597]	10 1/2" [267]	23" [584]	24 1/4" [616]
06	27 1/2" [699]	11 7/8" [302]	30" [762]	31" [787]
08	35 1/2" [902]	11 3/8" [289]	37" [940]	38" [965]
09	39 1/2" [1003]	11 1/2" [292]	41" [1041]	42 1/4" [1073]
10	51 1/2" [1308]	10 3/8" [264]	23" [584]	52" [1321]
12	59 1/2" [1511]	10 3/8" [264]	27" [686]	60" [1524]

NOTES:
1. All dimensions are inches [millimeters]. All dimensions ±1/4"[6mm]. Metric values are soft conversions.
2. Left hand unit shown, right hand unit opposite.
3. Provide sufficient clearance to access electrical controls and comply with applicable codes and ordinances.
4. Drain piping should be routed through casing opening indicated to provide proper slope.
5. Bottom panel removable for access to filter and fan assembly.
6. Corner panels are removable to access electrical enclosure, coil and valve pack.
7. Internal insulation of field piping may be required.
8. Field piping casing penetrations must be cut in the field to match individual job requirements.
9. All dimensions also apply to units with Electric Heat Only.

UNCONTROLLED WHEN PRINTED

ENVIRO-TEC®


THIS DRAWING CONTAINS PROPRIETARY DATA. UNAUTHORIZED DISCLOSURE, REPRODUCTION, OR USE IS STRICTLY PROHIBITED WITHOUT WRITTEN PERMISSION.

SUBMITTAL DRAWING
ALL DRAWINGS ARE SUBJECT TO CHANGE WITHOUT PRIOR NOTICE

DO NOT SCALE DRAWING
DIMENSIONS ARE IN INCH [MM] FORMAT
+/- 1/8 [3] UNLESS OTHERWISE NOTED

TITLE: **MODEL HLE EXPOSED FAN COIL UNIT SERIES D BOTTOM RETURN**

DATE	SHEET	DRAWING NO	REV
10/4/19	PAGE 2 OF 3	47-80117	B

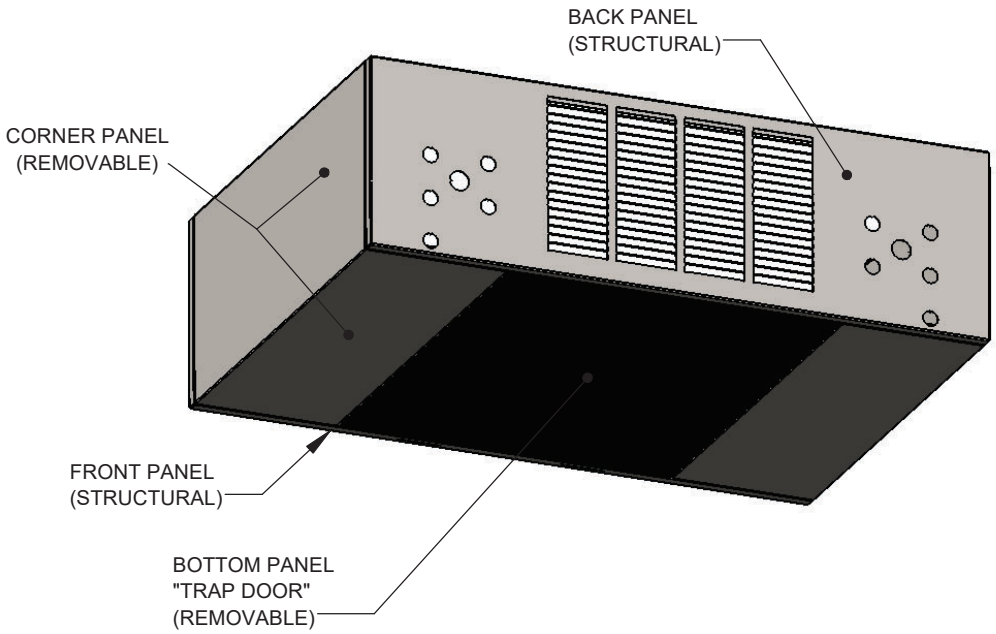




FRONT VIEW
TRAP DOOR OPENED 1" [25]



RIGHT VIEW
TRAP DOOR OPENED 1" [25]

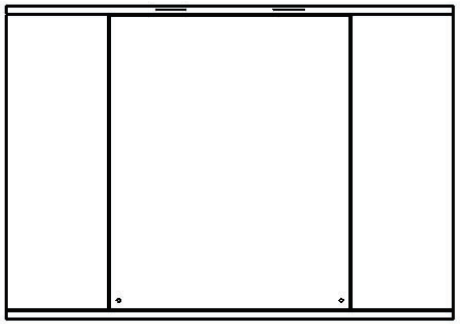

BOTTOM VIEW
TRAP DOOR OPENED 1" [25]

UNCONTROLLED WHEN PRINTED

ENVIRO-TEC®

THIS DRAWING CONTAINS PROPRIETARY DATA. UNAUTHORIZED DISCLOSURE, REPRODUCTION, OR USE IS STRICTLY PROHIBITED WITHOUT WRITTEN PERMISSION.


SUBMITTAL DRAWING
ALL DRAWINGS ARE SUBJECT TO CHANGE WITHOUT PRIOR NOTICE

DO NOT SCALE DRAWING
DIMENSIONS ARE IN INCH [MM] FORMAT
+/- 1/8 [3] UNLESS OTHERWISE NOTED


TITLE:
MODEL HLE EXPOSED FAN COIL UNIT SERIES D SERVICE ENVELOPE


DATE	SHEET	DRAWING NO	REV
4/7/16	PAGE 1 OF 4	47-80118	00

HEIGHT RESTRICTED APPLICATION

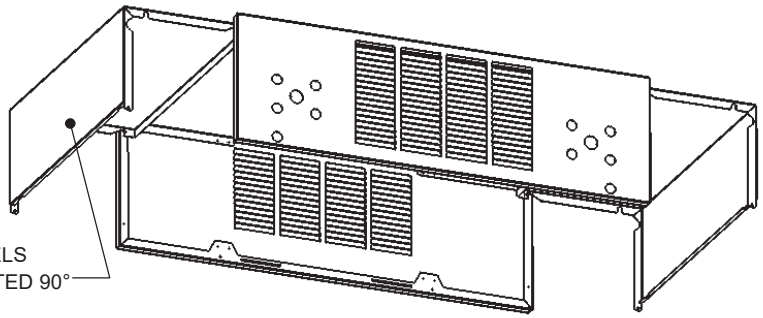



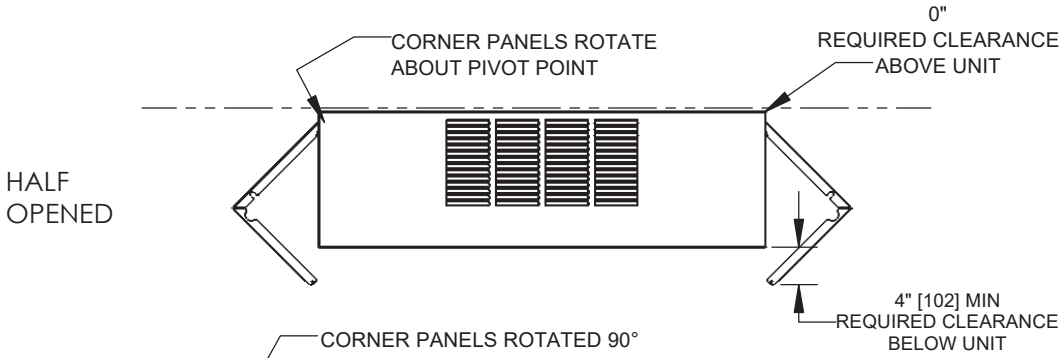

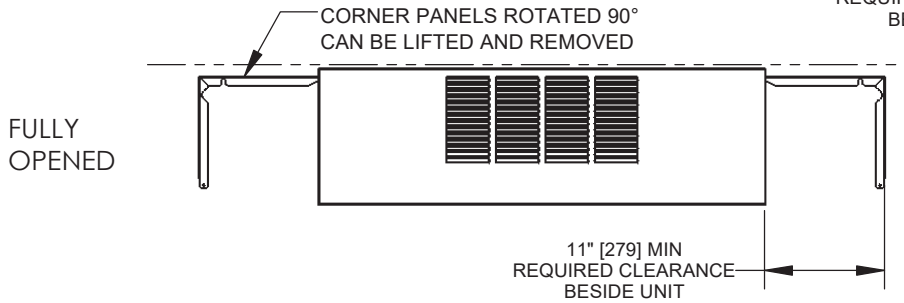

UNCONTROLLED WHEN PRINTED

ENVIRO-TEC®

THIS DRAWING CONTAINS PROPRIETARY DATA. UNAUTHORIZED DISCLOSURE, REPRODUCTION, OR USE IS STRICTLY PROHIBITED WITHOUT WRITTEN PERMISSION.


SUBMITTAL DRAWING
ALL DRAWINGS ARE SUBJECT TO CHANGE WITHOUT PRIOR NOTICE

DO NOT SCALE DRAWING
DIMENSIONS ARE IN INCH [MM] FORMAT
+/- 1/8 [3] UNLESS OTHERWISE NOTED


TITLE:
MODEL HLE EXPOSED FAN COIL UNIT
SERIES D SERVICE ENVELOPE

DATE	SHEET	DRAWING NO	REV
4/7/16	PAGE 2 OF 4	47-80118	00

WIDTH RESTRICTED APPLICATION

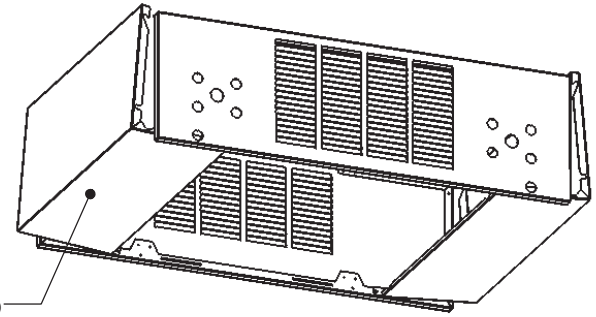

CORNER PANELS SHOWN LIFTED AND ROTATED 5°

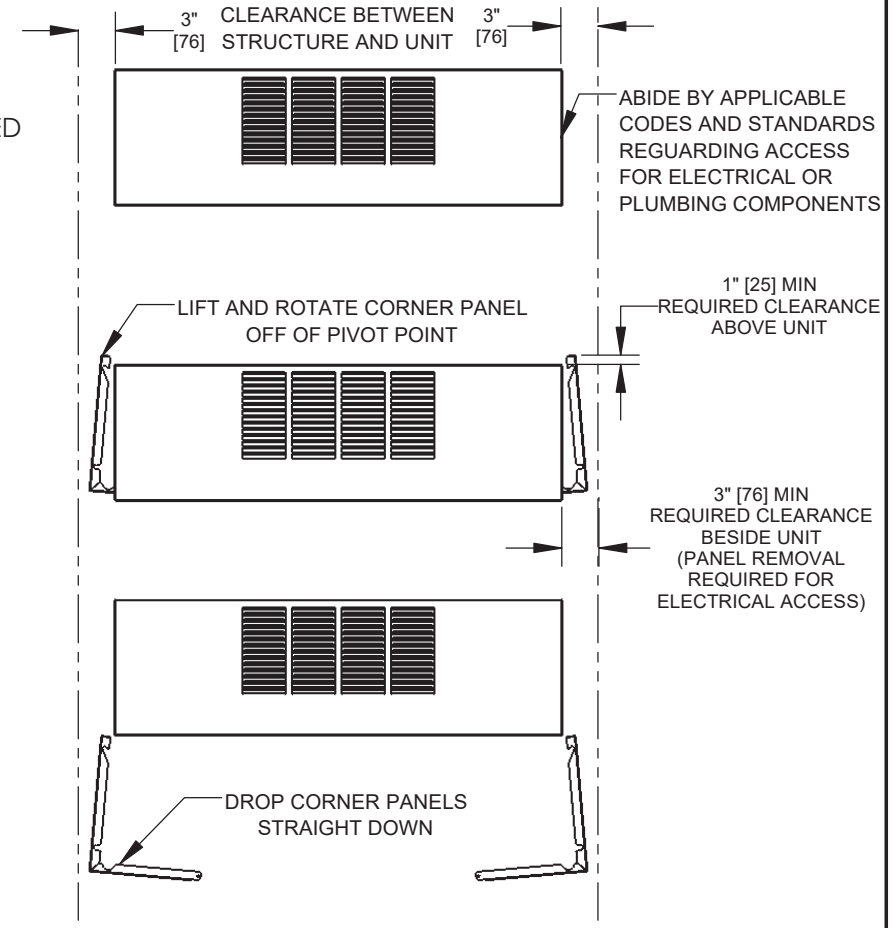

UNCONTROLLED WHEN PRINTED

ENVIRO-TEC®


THIS DRAWING CONTAINS PROPRIETARY DATA. UNAUTHORIZED DISCLOSURE, REPRODUCTION, OR USE IS STRICTLY PROHIBITED WITHOUT WRITTEN PERMISSION.

SUBMITTAL DRAWING
ALL DRAWINGS ARE SUBJECT TO CHANGE WITHOUT PRIOR NOTICE


DO NOT SCALE DRAWING
DIMENSIONS ARE IN INCH [MM] FORMAT
+/- 1/8 [3] UNLESS OTHERWISE NOTED

TITLE: **MODEL HLE EXPOSED FAN COIL UNIT SERIES D SERVICE ENVELOPE**

DATE	SHEET	DRAWING NO	REV
4/7/16	PAGE 3 OF 4	47-80118	00

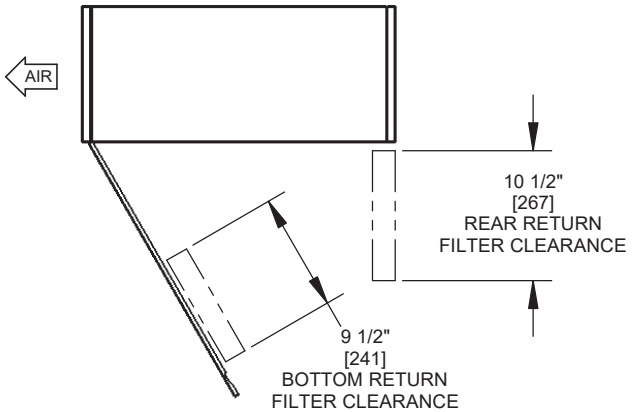

RIGHT VIEW
FILTER ACCESS DETAIL
TRAP DOOR OPENED

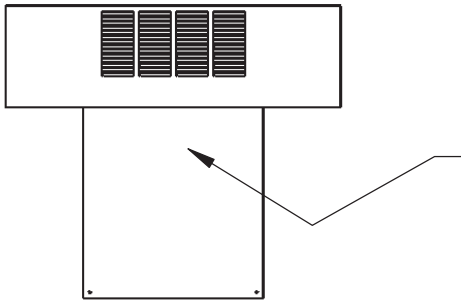

FRONT VIEW
ACCESS SEQUENCE
DETAIL 1

TRAP DOOR RETAINED BY 1/4 TURN HARDWARE
SWINGS OPEN ON INTEGRATED HINGE-FLANGE
OPEN TRAP DOOR TO ACCESS:

- AIR FILTER
- BLOWER ACCESS PANEL
- ELECTRIC HEAT ACCESS PANEL
- CORNER PANEL MOUNTING HARDWARE



FRONT VIEW
ACCESS SEQUENCE
DETAIL 2

AFTER OPENING TRAP DOOR
CORNER PANELS MAY BE REMOVED
EACH CORNER PANEL RETAINED BY QTY (2)
#10 HEX HEAD SCREWS
OPEN CORNER PANELS TO ACCESS:

- ELECTRICAL ENCLOSURE
- VALVE PACKAGE

UNCONTROLLED WHEN PRINTED

ENVIRO-TEC®

THIS DRAWING CONTAINS PROPRIETARY DATA. UNAUTHORIZED DISCLOSURE, REPRODUCTION, OR USE IS STRICTLY PROHIBITED WITHOUT WRITTEN PERMISSION.

SUBMITTAL DRAWING
ALL DRAWINGS ARE SUBJECT TO CHANGE WITHOUT PRIOR NOTICE

DO NOT SCALE DRAWING
DIMENSIONS ARE IN INCH [MM] FORMAT
+/- 1/8 [3] UNLESS OTHERWISE NOTED

TITLE:
MODEL HLE EXPOSED FAN COIL UNIT
SERIES D SERVICE ENVELOPE

DATE	SHEET	DRAWING NO	REV
4/7/16	PAGE 4 OF 4	47-80118	00